




DO NOT SCALE ALL DIMENSIONS ARE IN mm UNLESS OTHERWISE NOTED

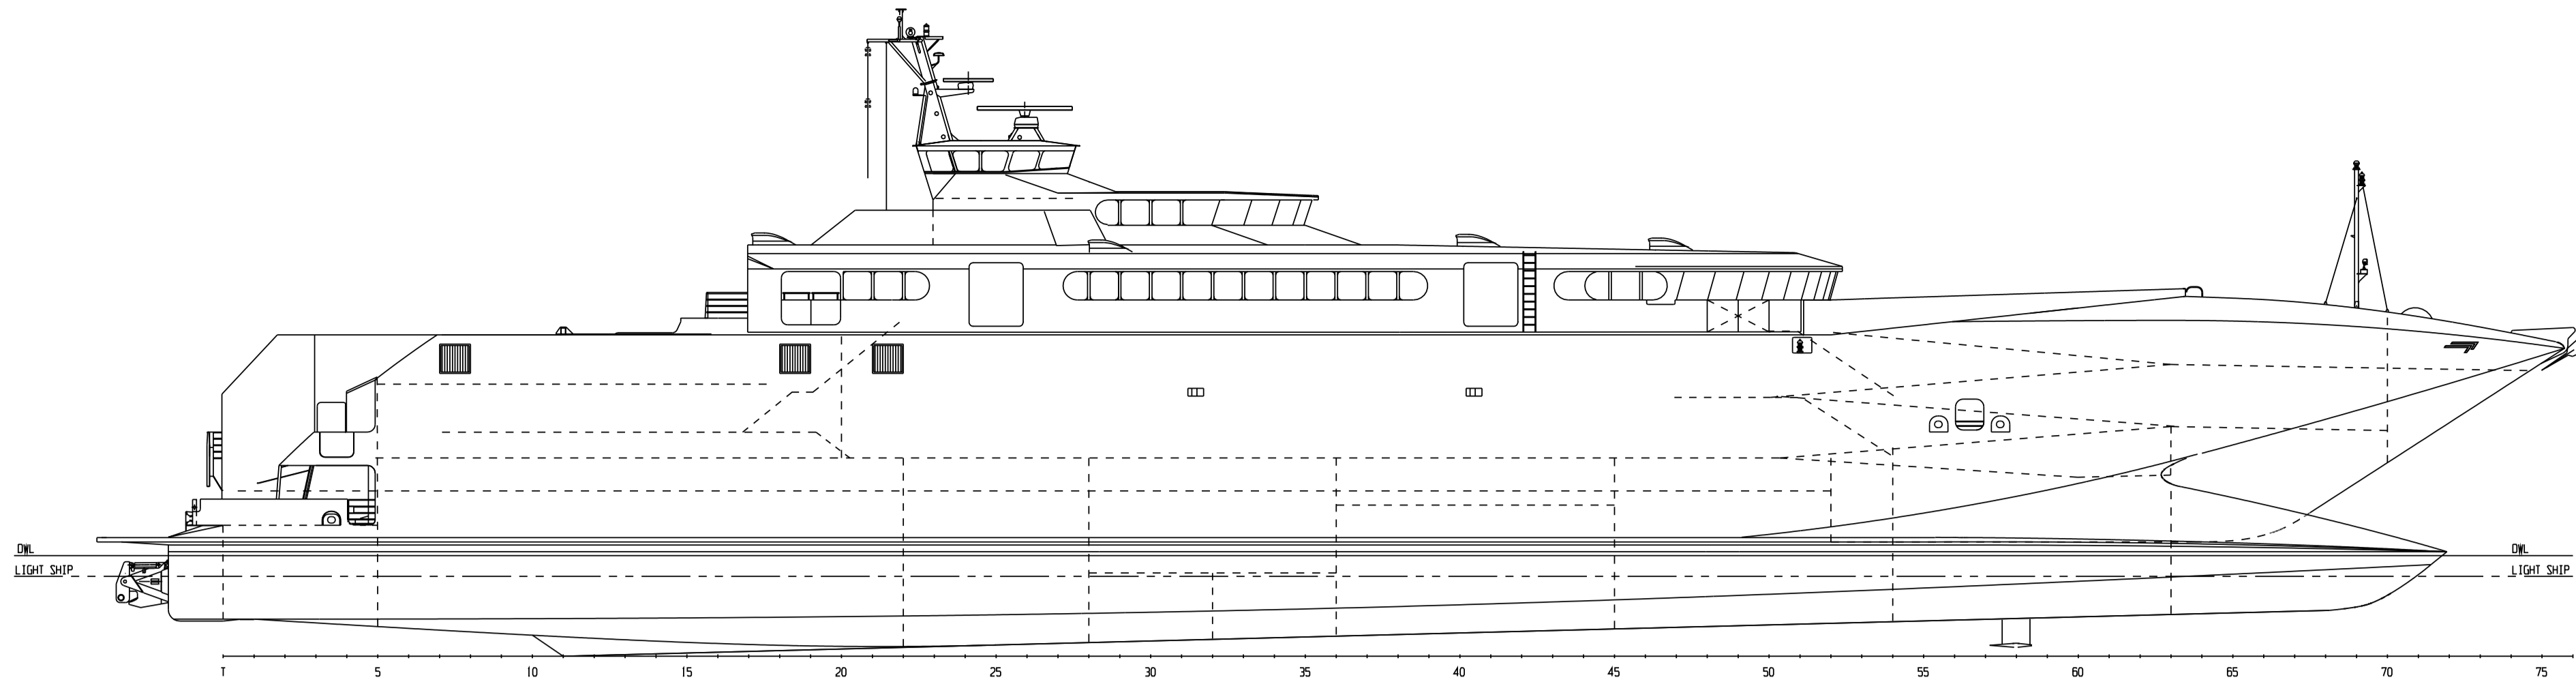


PROFILE

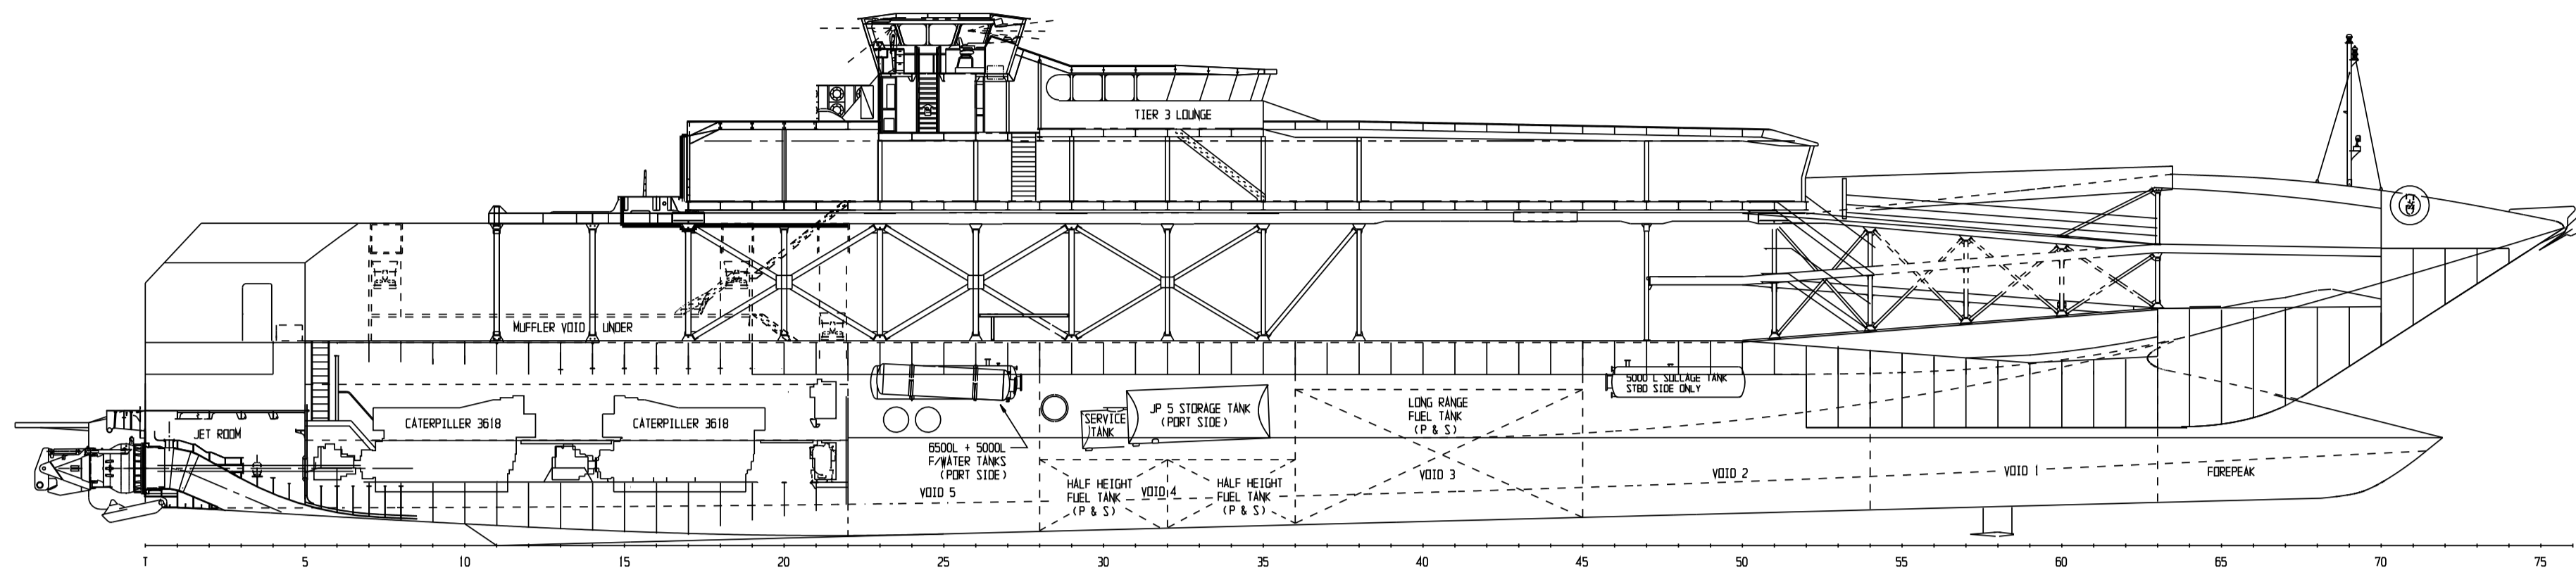


INBOARD PROFILE

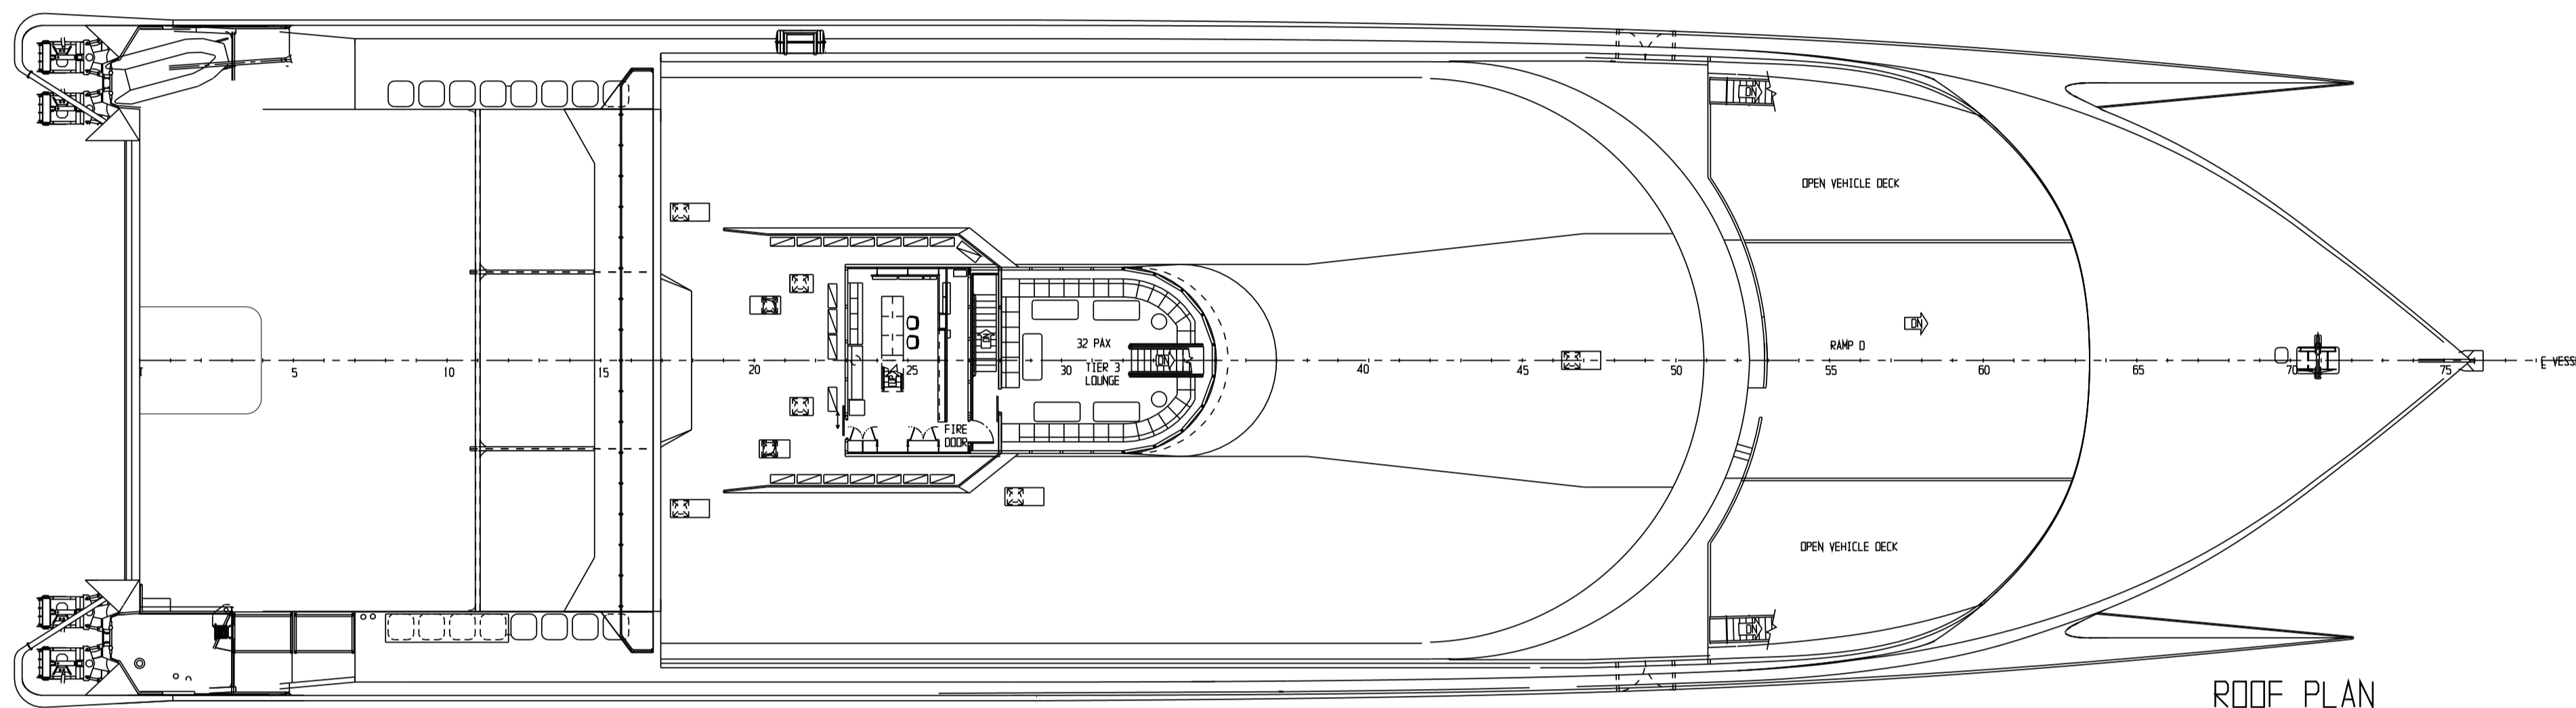


ROOF PLAN

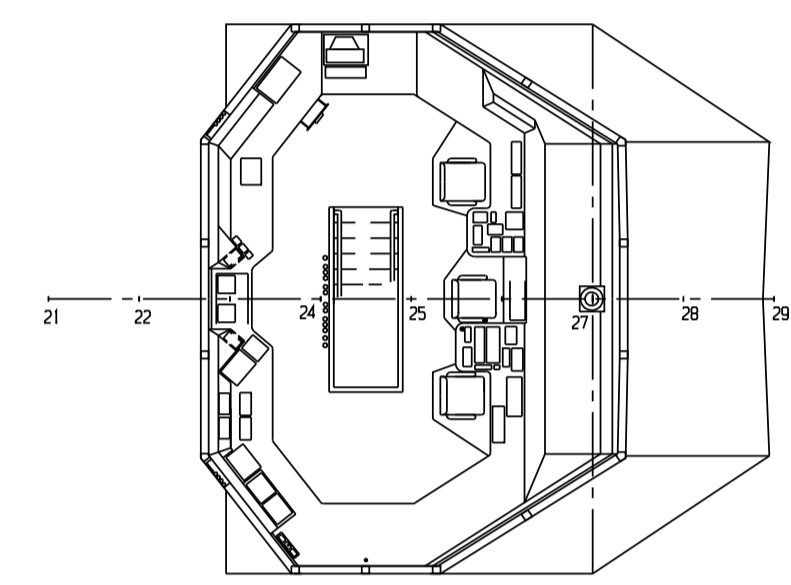


WHEELHOUSE PLAN
SCALE 1:100

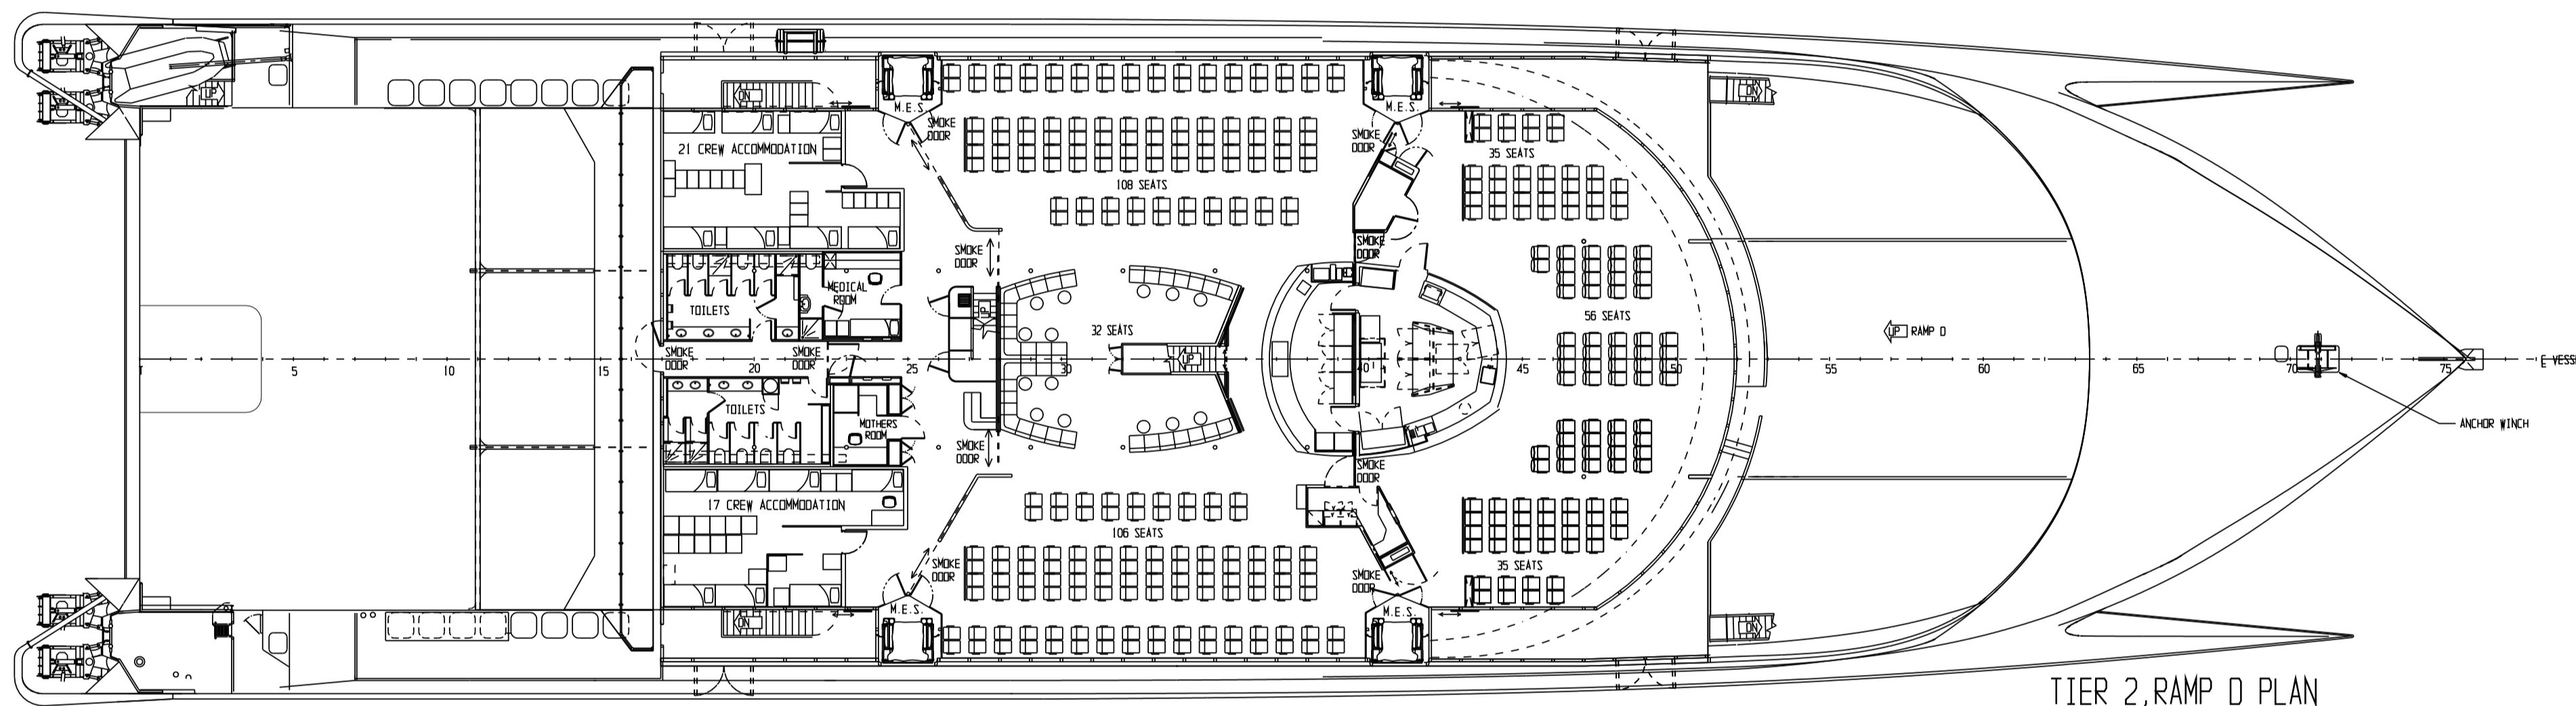


TIER 2, RAMP D PLAN

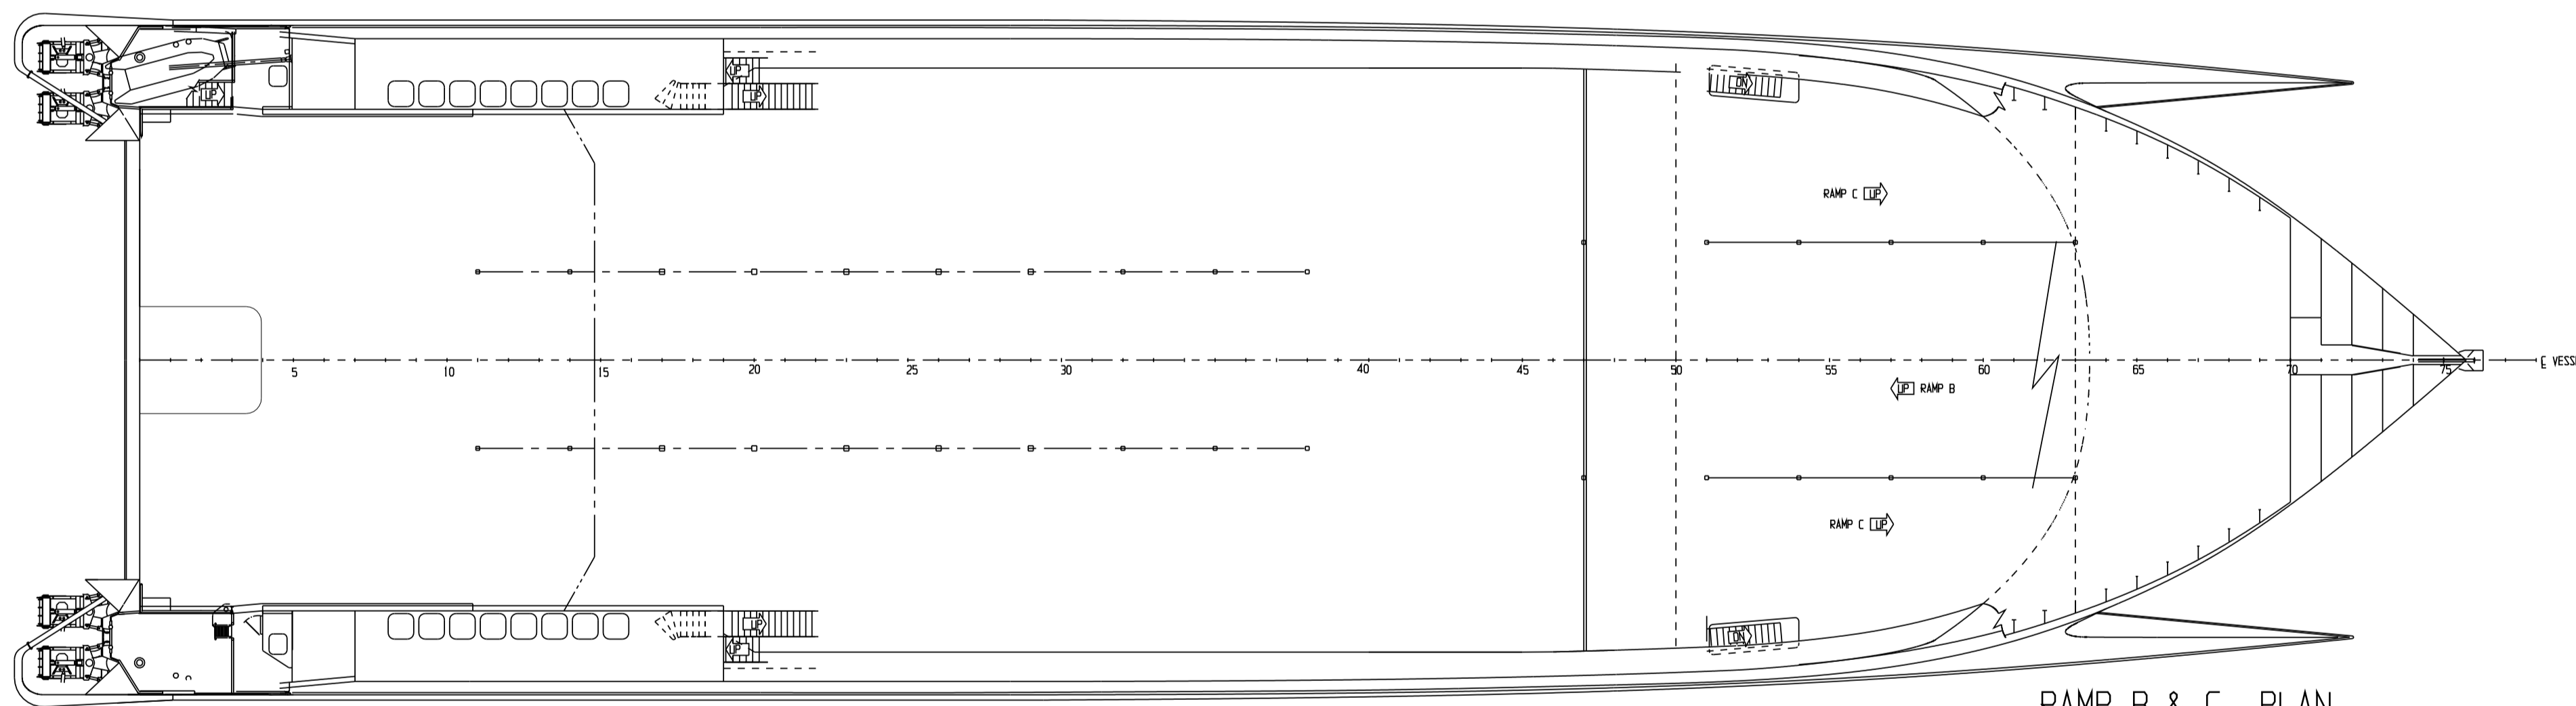

RAMP B & C PLAN

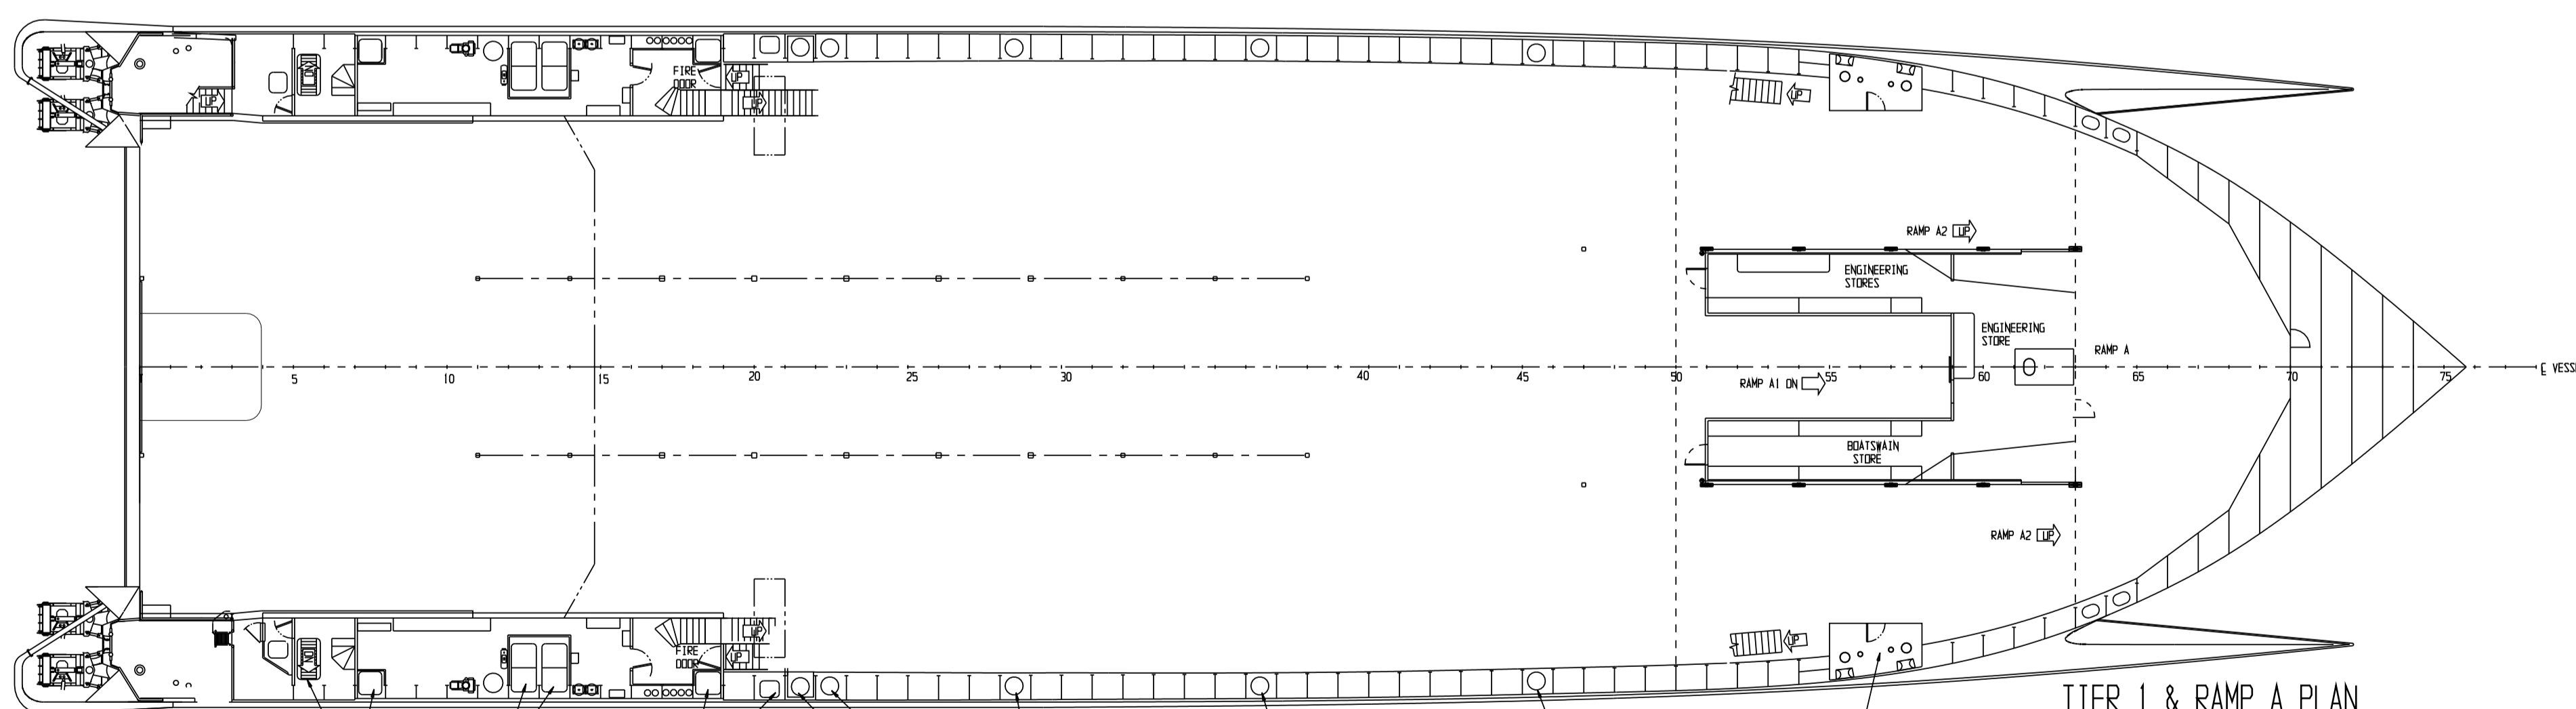

TIER 1 & RAMP A PLAN

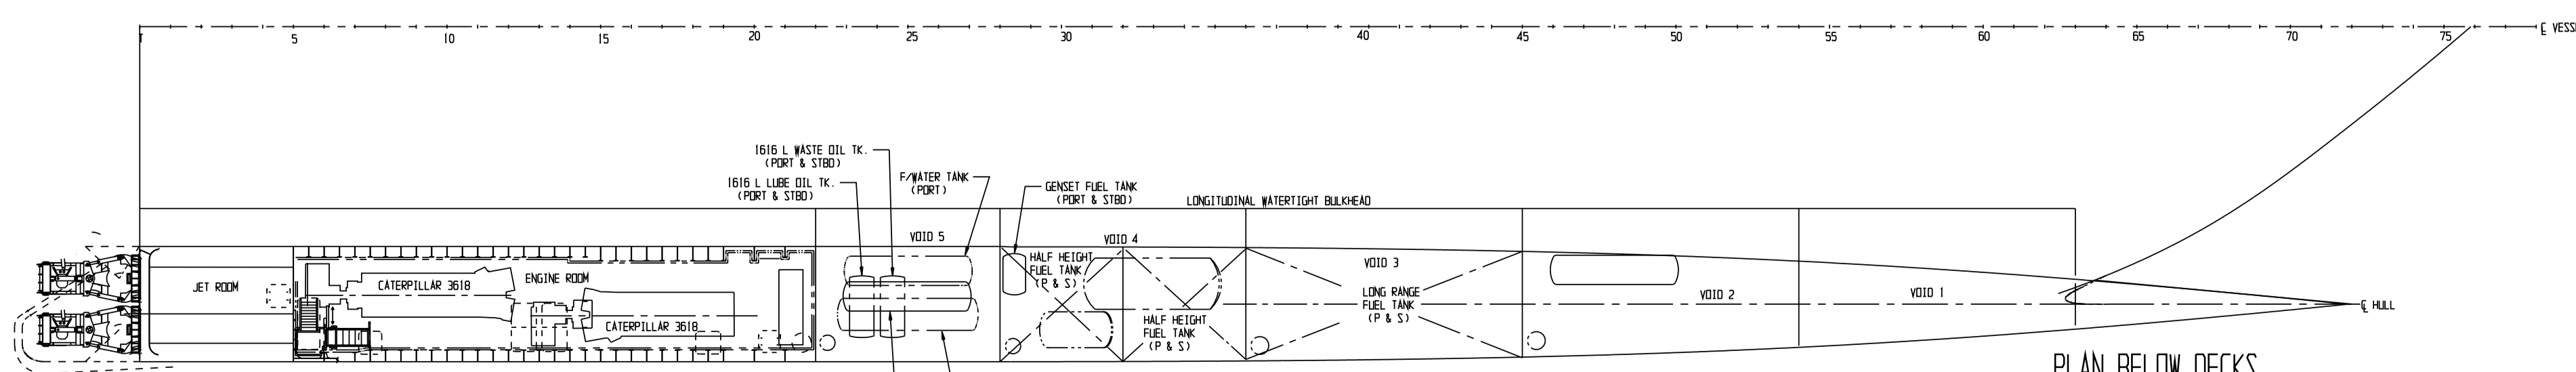

PLAN BELOW DECKS

Rev. No	Date	Drawn/Chk	Description
M 2004	20/01/07	TR	SEAT NUMBERS UPDATED.
L 2003	15/01/07	GJ	DOORWAY ADDED AT TIER 2 AFT PASSAGE.
K 2003	03/01/07	GJ	HELD DECK & V/DECK AFT RAMPS REMOVED. TIER 2 AFT BALCONY ADDED. TIER 2 SEATING LAYOUT REARRANGED. ALL MILITARY EQUIPMENT REMOVED.
J 120	7-APR-05	BES CAP	UPDATE TO "AS BUILT"
H 120	25 FEB '05	BES CAP	NUMBER OF WORKSTATION SEATS IN FWD LOUNGE CHANGED FROM 18 TO 16. STBD ANTE ROOM AIRLOCK & ENGINE ROOM AIR INTAKE SHROUD ADDED.
G 120	16 FEB '05	BES CAP	MED. TREATMENT RM UPDATED. EXTRA SEATING TO ADMIN. RM & T3 LOUNGE. PORT SIDE TEMP. BIRTHS RE-ARRANGED. RAMP C AMENITIES UPDATED. AMMO LOCKERS RELOCATED. MUGS ADDED. JP 5 REFUELING UNIT ADDED. VEHICLE DECK STORAGE REARRANGED. EXTRA TANKS BELOW DECK SHOWN.
F 120	7 DEC '04	CAP BES	INTERIOR MODS. LAUNDRY MOVED TO RAMPS B & C
E 120	17 NOV '04	CAP	UPDATES TO REFLECT SDCOM DESIGN EFFORT // TITLE BLOCK UPDATED
D 120	24 JUN '04	CAP	GENERAL UPDATES TO SUIT MARCOM PROPOSALS
C 120	03 Nov '03	CAP BES	UPDATE OF AFT CREW ACCOMMODATION. KITBOX CHANGED TO GALLEY. CREW/GYM ADDED PORT SIDE PAX DECK. RAMP A1 STORES ADDED
B 120	13-8-01	JML	INSTRUMENT ROOM RELOCATED
A 120	9-AUG-01	JML	PASSENGER & ACCOMMODATION AREAS ADJUSTED AS REQUESTED

Client/Project: INCAT/ OSO Class approval number: Rev. sent: Approved:

16 Bender Drive Moorah Tasmania 7009 Australia
 PHONE/FACSIMILE +61 3 6274 1845
 EMAIL: revolut@evolutiondesign.com.au
 INTERNET: www.revolutiondesign.com.au

evolution DESIGN PTY LTD

Title: 96 m WAVE PIERCING CATAMARAN FERRY Scale: 1:200
 Checked: CAR Date: 20 Jun'01
 Designed: Job Number: XXX-32-01
 Dwg. No: 050-09-32-001 Rev. M

DRAWING No: TO BE READ IN CONJUNCTION WITH: